

Coordination transmittal and sheet index

Orion Biologics | Suite 214 laboratory renovation | record package

RECORD ISSUE

REVISION C

This package assembles the architectural, technology, electrical, field-response, and closeout records issued for coordination. Retain each sheet identity, revision, and issue authority throughout coordination use.

CONTROLLED SHEET INDEX

Sheet	Record	Rev	Issued	Class
TX-01	Transmittal / index	C	16 Jun	Record
A2.14-B	Archived floor plan	B	07 Jun	Archive
A2.14	Controlled floor plan	C	12 Jun	Construction
A6.24	RCP / MEP coordination	C	12 Jun	Coordination
T4.08	Rack R2 / patching	C	13 Jun	Coordination
N1.07	Network / access topology	C	13 Jun	Coordination
E6.02	LP-2 / field check	C	14 Jun	Field check
RFI-214-17	Door field response	A	12 Jun	Response
PH-214	Field photo record	A	15 Jun	Photo record
CL-214	Final issue release	C	16 Jun	Release


REVISION AND AUTHORITY REGISTER

Event	Date	Authority	Record effect
Rev B issue	07 Jun	MS	Archived background
RFI response	12 Jun	AV	Incorporated by Rev C
Rev C issue	12 Jun	AV	Controls coordination
Record release	16 Jun	LS	Closes package

Authority order: final release, Revision C sheets, answered RFI, archived Revision B record.

A2.14-B - Archived floor plan

Record background | not for current coordination

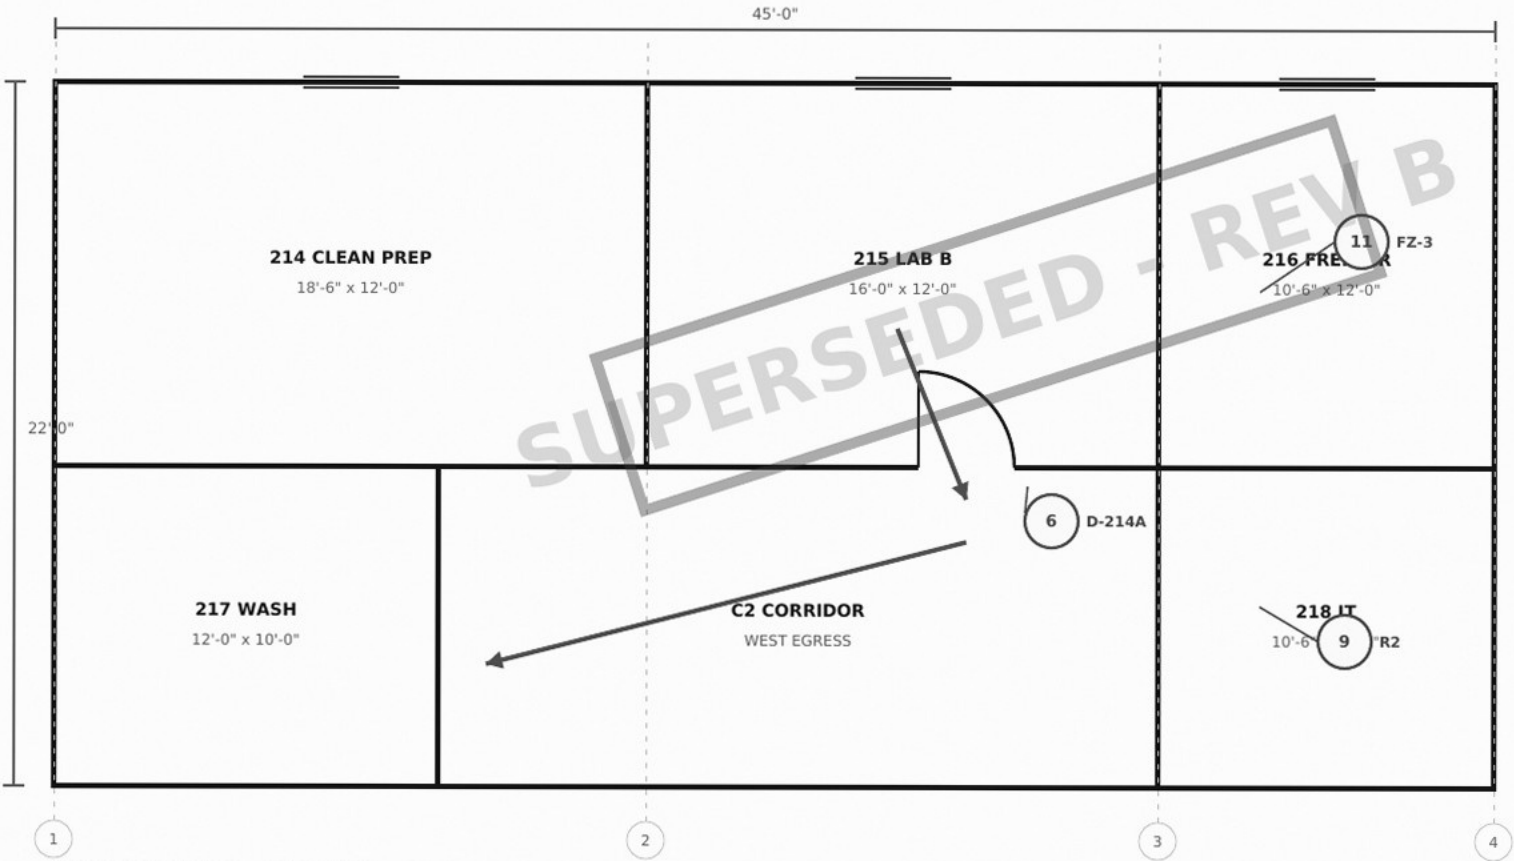


ISSUED 07 JUN 2026 DRAWN MS CHECKED AV



FIELD BACKGROUND 214-B-0707

A2.14 - Controlled floor plan and overlay

Coordinated issue | current geometry shown solid blue; archived opening shown dashed red

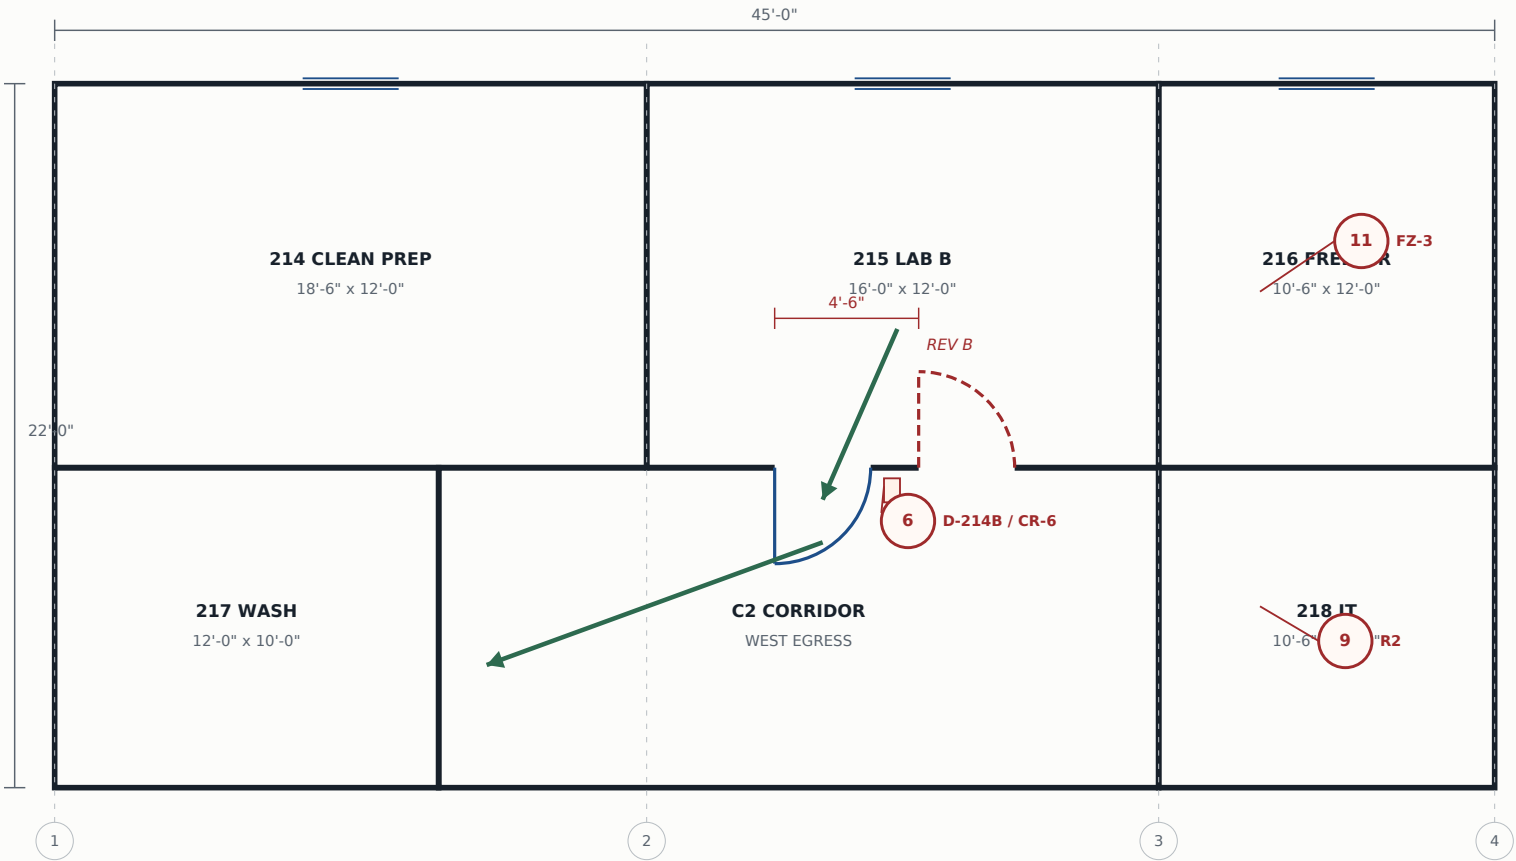


ISSUED 12 JUN 2026 DRAWN MS CHECKED AV



COORDINATION RECORD A2.14-C

A6.24 - Reflected ceiling and MEP coordination


Suite 214 ceiling zones | device geometry and conflict resolution

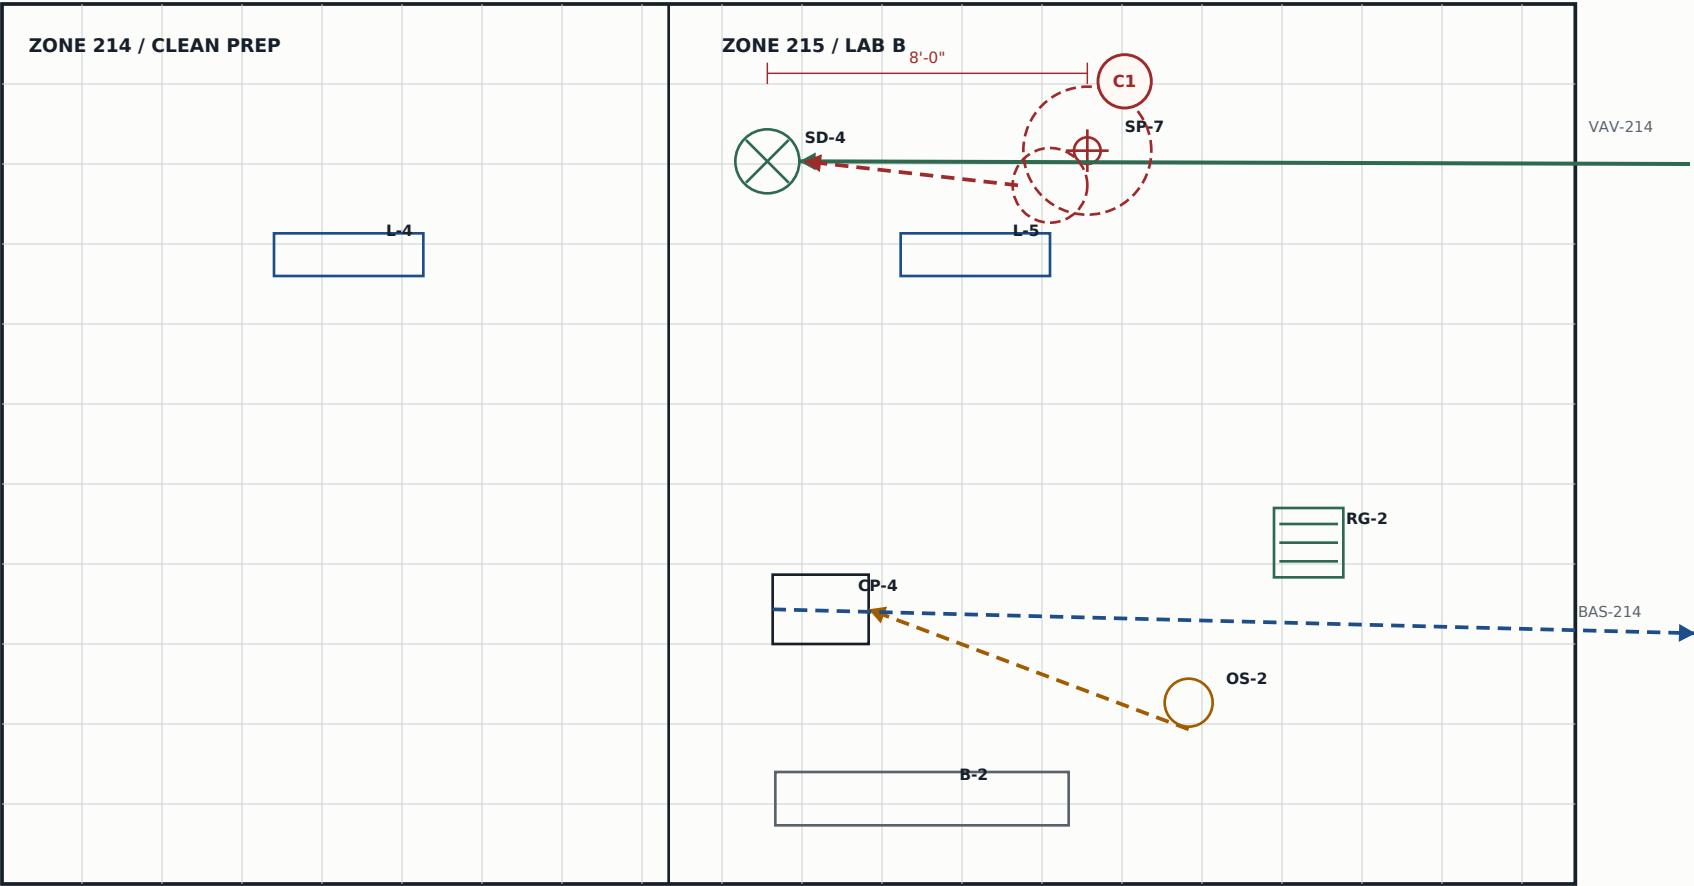

SYMBOL KEY solid green: supply dashed amber: sensor control dashed blue: BAS data dashed red: relocated

T4.08 - Rack R2 elevation and patching


IT Closet 218 | front elevation | coordinated ports only

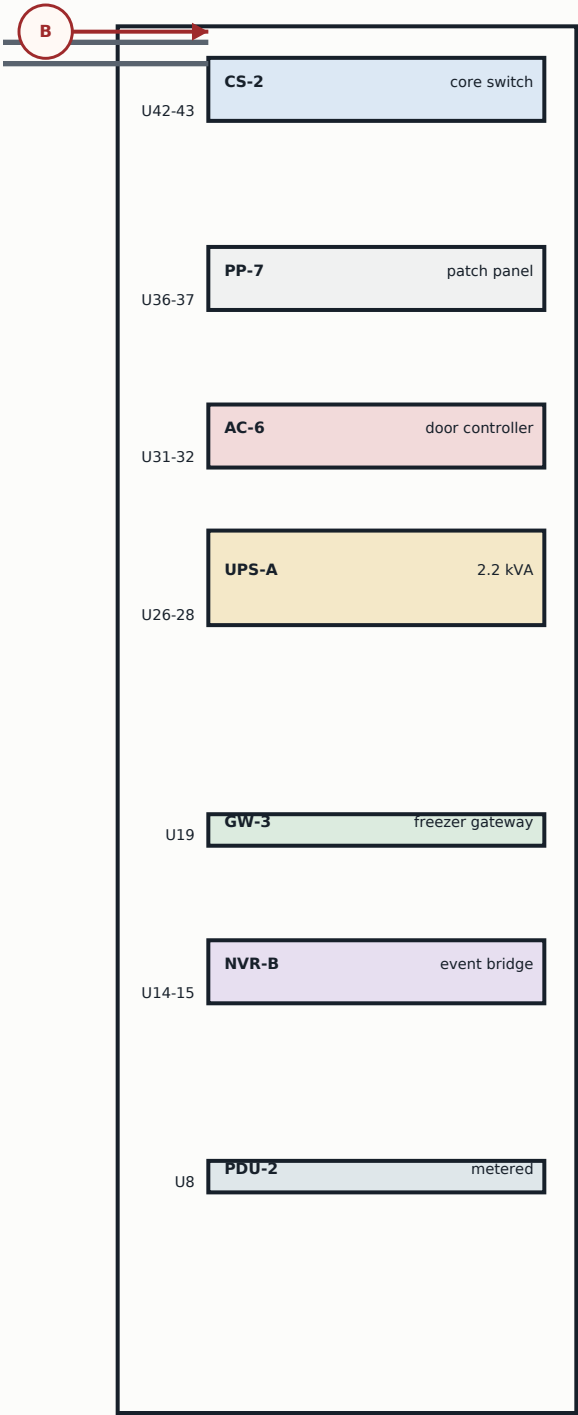

PATCH AND ENDPOINT SCHEDULE


Port	Drop	Endpoint	Location	VLAN	Medium
CS-2/01	D214-01	Tablet dock	214-W	210	Cat6A
CS-2/07	D215-03	CR-6	215-S	230	Cat6A
CS-2/08	D215-04	DC-6	R2/U31	230	Cat6A
CS-2/12	D216-02	FZ-3	216-E	240	Cat6A
CS-2/13	D216-03	GW-3	R2/U19	240	Cat6A
CS-2/19	D218-01	FW-02 mgmt	218-R2	99	Cat6A
PP-7/21	D214-11	BAS-214	214-N	120	OM4
PP-7/22	D215-12	CP-4	215-CLG	120	OM4

INTERNAL PATCH PATHS

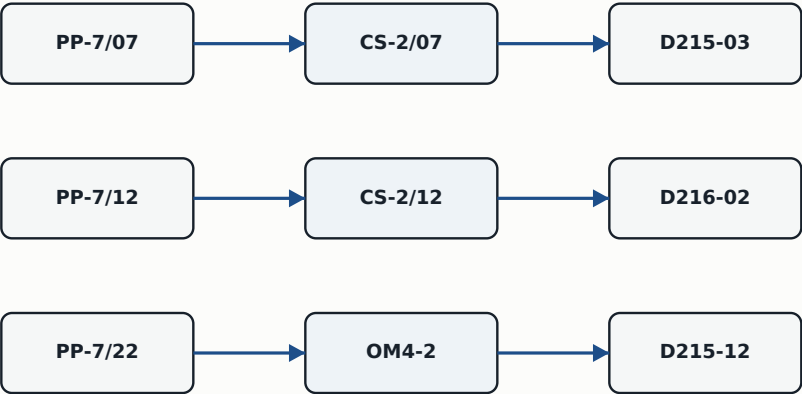

N1.07 - Network and access-control topology

Directed service paths | solid operational edges | dashed conditional edge

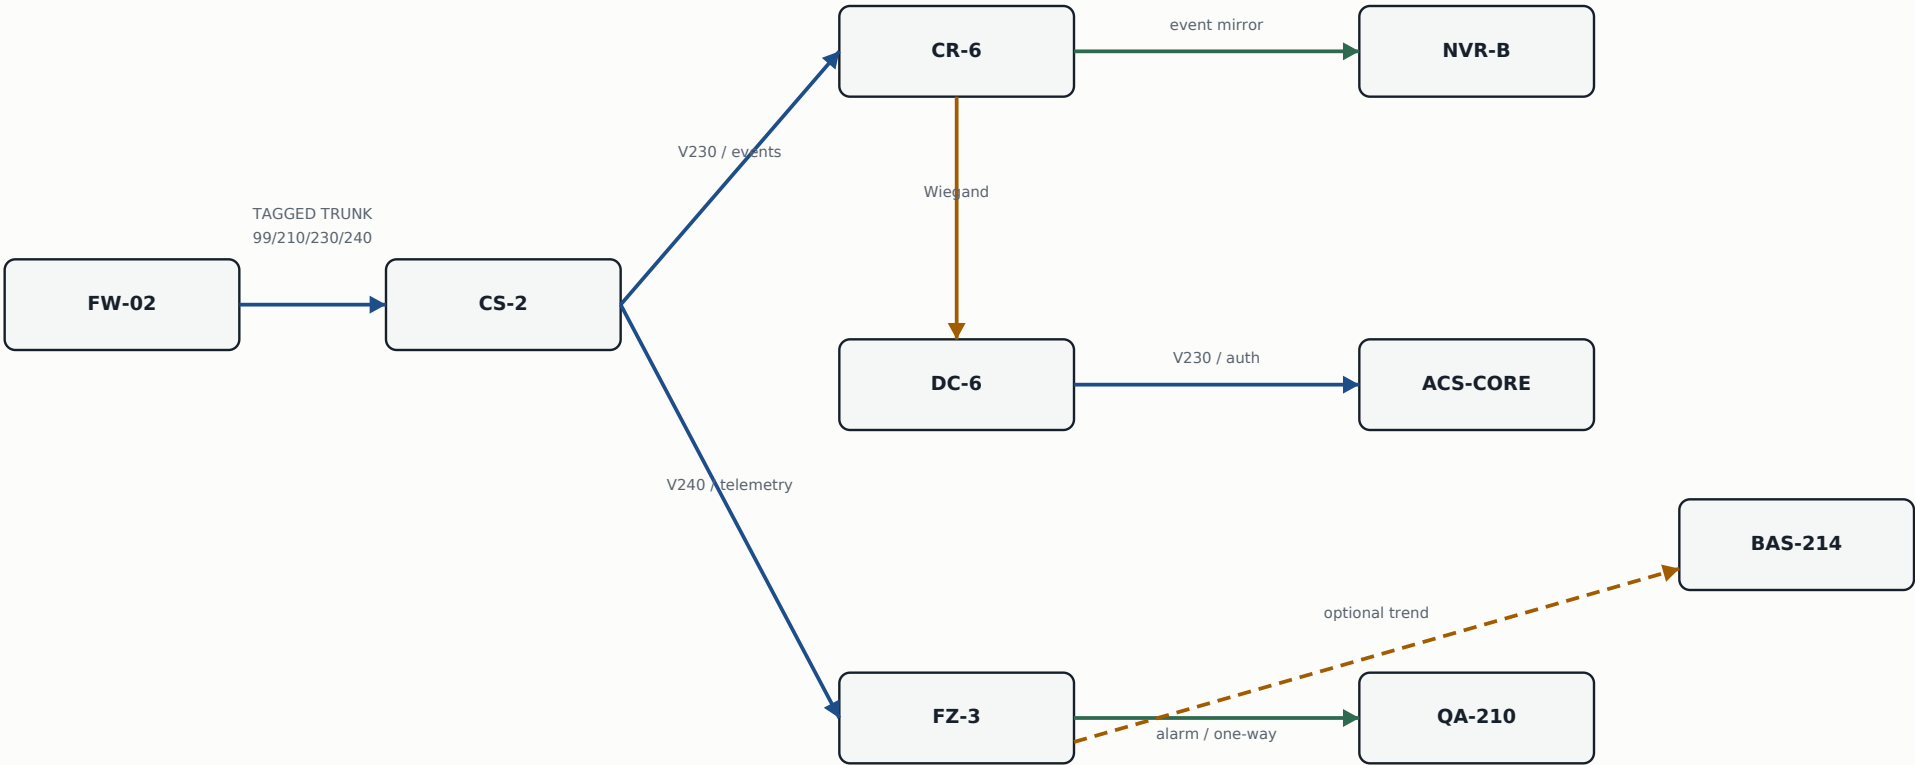

Path key	Transport	Mode	Policy
ACL-230-A	V230	Auth	Permit one-way
MIR-230-B	V230	Event	Permit one-way
TEL-240-Q	V240	Alarm	Permit one-way
OPT-240-B	V240	Trend	Conditional

E6.02 - Panel LP-2 and field check

LP-2 branch schedule with field walkdown record

Circuit	Load	Breaker	Branch	Room	Record
L2-11	Bench outlets B	20A/1P	Normal	215	B-2
L2-13	Autoclave AC-1	30A/2P	Normal	217	AC-1
L2-15	Door controller	20A/1P	Emergency	215	DC-6
L2-17	Freezer	20A/1P	Emergency	216	FZ-3
L2-19	Rack UPS	20A/1P	Emergency	218	UPS-A
L2-21	Spare	20A/1P	Normal	-	Future

EMBEDDED FIELD WALKDOWN RECORD

LP-2 CONTROL POWER FIELD CHECK

Record EC-214-19 Area 214-218 Walkdown 14 JUN 2026

☒ Torque witness marks complete

☒ L2-15 field tag installed

☒ L2-17 field tag installed

☒ L2-19 field tag installed

☐ L2-21 released for use

☒ Emergency transfer witnessed

☒ Reader polarity exception open

Technician: JH

Witness: LS

Panel energized 16:42

FIELD COPY

RFI-214-17 - Lab B corridor opening

Field response and marked plan excerpt

FIELD QUERY / RECEIVED 09 JUN 2026

Revision B opening conflicts with the installed security rough-in. Confirm governing opening, swing, reader jamb, controller branch, and whether the old field background may be used for set-out.

VOID

☐ Maintain D-214A at Revision B position

☒ Issue architect response for construction

ARCHITECT RESPONSE / AV / 12 JUN

VOID D-214A SET-OUT.


Shift opening 4'-6" west.

Use D-214B; swing south into C2.

Set CR-6 on corridor-side east jamb.

DC-6 branch is LP-2 / L2-15.

Revision C governs construction.

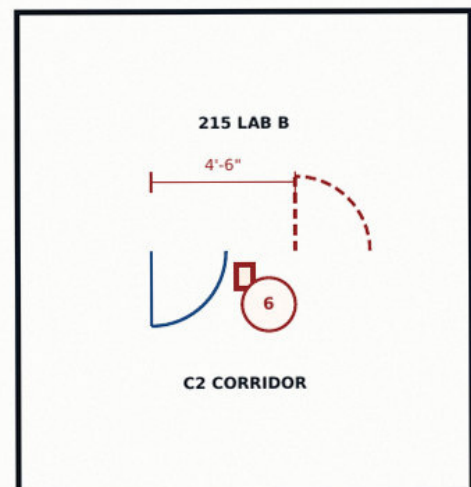

Architect AV signed 12 JUN 2026 Security TN reviewed Contractor RK acknowledged 13 JUN 2026

PH-214 - Field photo and punch evidence

Photographs retained at inspection resolution | annotation keys only

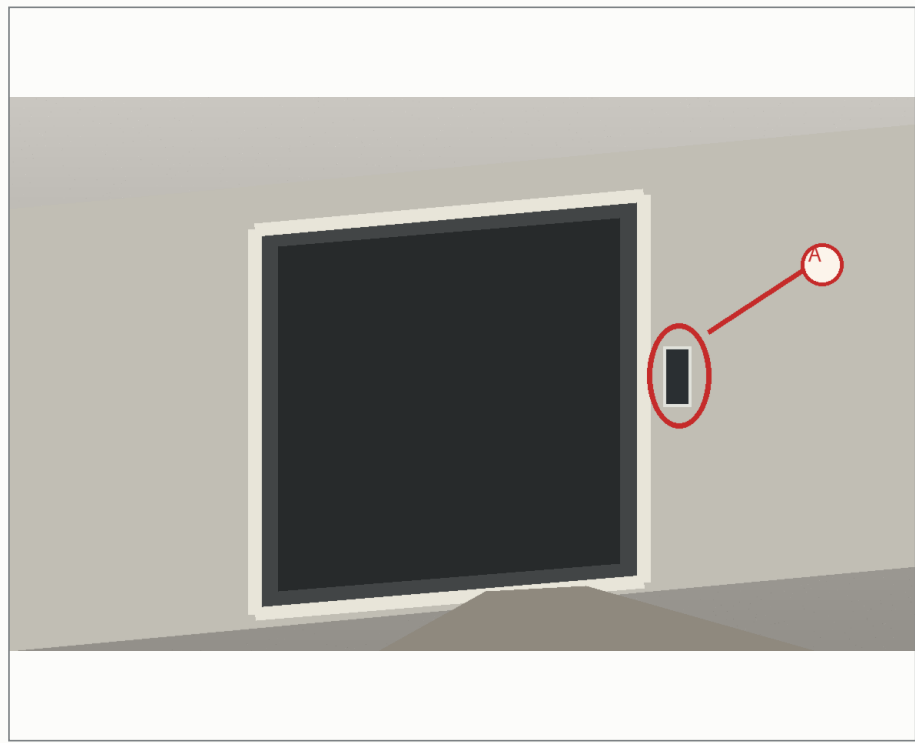


PHOTO 06 | CORRIDOR C2 | KEY A

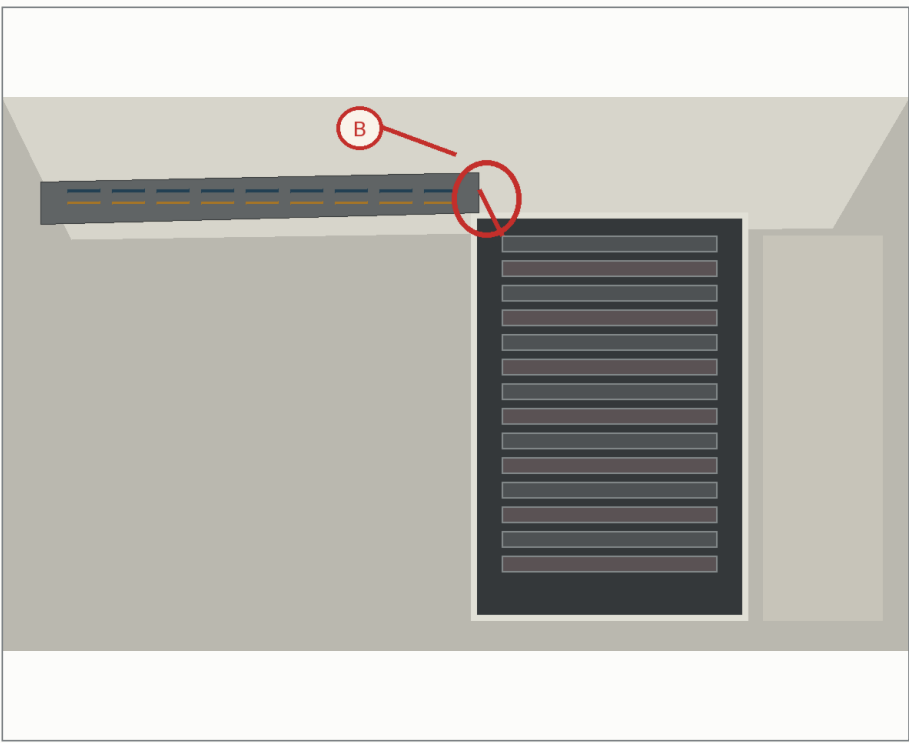


PHOTO 09 | ROOM 218 | KEY B

Image	Captured	View	Custodian	Checksum
PHOTO 06	15 Jun 09:16	C2 south	TN	8F4C-06A2
PHOTO 09	15 Jun 09:42	218 west	TN	1B77-09D5

CL-214 - Final issue and signoff record

Distribution manifest with embedded release authority

Artifact	Revision	Digest	Recipient	Time
A2.14	C	2E11-A214	Field / RK	17:22
A6.24	C	9A40-A624	MEP / JH	17:22
T4.08	C	B817-T408	Security / TN	17:23
N1.07	C	0C31-N107	IT / SM	17:23
E6.02	C	7D14-E602	Electrical / JH	17:24
RFI-214-17	A	6F82-R214	Record / LS	17:24

EMBEDDED FINAL RELEASE

FINAL ISSUE RELEASE / RECORD COPY

Package ARC-214-C Release 16 JUN 2026 17:20

☒ IFC Revision C accepted

☐ Use archived Revision B background

☒ RFI-214-17 incorporated

☐ Open access-control punch items

Architect AV Security TN Electrical JH Owner LS

Release seal 214-C-0616

ISSUED

16 JUN 2026